


RECORD DRAWING	
DESIGNED: R. SINGLETON	DATE: 12/13/19
DRAWN: S. PULIDO	DATE: 12/13/19
CHECKED: S. ARTAL	DATE: 12/16/19

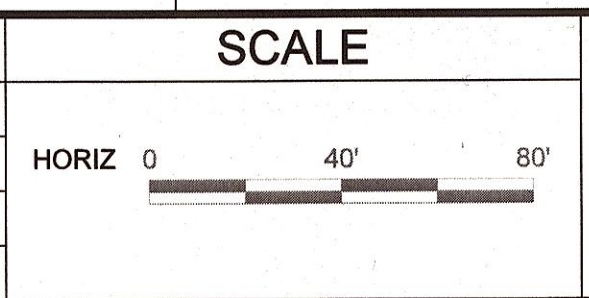

DATE: 1/24/2020

PROJECT

CANTUA CREEK SUBDIVISION  
WASTEWATER TREATMENT NEW

ROAD NO. N/A BRIDGE NO. N/A

DEPARTMENT OF PUBLIC WORKS AND PLANNING

CANTUA CREEK WWTF  
IMPROVEMENTS

DRAWING NO. 11300 SHEET NO. 12 TOTAL 19

FOR RIGHT OF WAY DATA AND ACCURATE ACCESS DETERMINATION, SEE DOCUMENTS IN THE DEPARTMENT OF PUBLIC WORKS AND PLANNING.